





CORRECTED TO SUIT SHIP			
PLACE	REV	DATE	APPROVED

NOTE  
THIS DRAWING SUPERSEDES  
BUSHIP DRAWING NO.S0103-578361  
FOR USS WISCONSIN BB-64  
ONLY.

SELECTED RECORD DRAWING

# BB-64 USS WISCONSIN

CLASSIFIED BY: DD 254 DTD 12 NOV 1985  
N00024-86-C-2043  
DECLASSIFY ON: OADR

ORDER OF PLANS	
TITLE	PLATE NO.
COVER SHEET	1
GENERAL DIMENSIONS & DATA	2
OUTBOARD PROFILE	3
INBOARD PROFILE	4
O3 THRU O12 LEVEL	5
O1 AND O2 LEVEL	6
MAIN DECK	7
SECOND DECK	8
SPLINTER DECK	9
THIRD DECK	10
FIRST PLATFORM	11
SECOND & THIRD PLATFORMS	12
HOLD	13
THIRD BOTTOM	14
INNER BOTTOM	15
SECTIONS	16
SECTIONS	17
SECTIONS	18

## BOOKLET OF GENERAL PLANS

PREPARED BY  
INGALLS SHIPBUILDING  
PASCAGOULA, MISSISSIPPI



GENERAL DIMENSIONS  
HULL

LENGTH OVER ALL (ACTUAL)	887'-3"
LENGTH BETWEEN PERPENDICULARS	860'-0"
BREADTH, EXTREME OVERALL	108'-3"
FULL DISPLACEMENT (APPROX)	55,649 TONS
MEAN DRAFT AT CENTER OF FLOTATION	34'-9 1/4"

MOLDED HEIGHTS OF BRIDGES &  
ELEVATED PLATFORMS AT C OF SHIP

	ABV BL
HEIGHT OF MAIN DECK AT STEM	69'-8 1/2"
HEIGHT OF MAIN DECK AT STERN	56'-3"
HEIGHT OF 01 LEVEL	60'-11"
HEIGHT OF 02 LEVEL	68'-5"
HEIGHT OF 03 LEVEL	75'-11"
HEIGHT OF 04 LEVEL	83'-5"
HEIGHT OF 05 LEVEL	90'-11"
HEIGHT OF 06 LEVEL	98'-5"
HEIGHT OF 07 LEVEL	105'-11"
HEIGHT OF 08 LEVEL	113'-5"
HEIGHT OF 09 LEVEL	121'-7 1/4"
HEIGHT OF 010 LEVEL	129'-9 1/2"
HEIGHT OF 011 LEVEL	138'-0"
HEIGHT OF 012 LEVEL	151'-6 1/2"

MOLDED BASE LINE OF SHIP IS 2" ABOVE BOTTOM OF KEEL

ANCHOR & RUNNING LIGHTS

NAME OF LIGHT	HGT ABV BASE LINE
AFT MASTHEAD LIGHT	163'-11 1/8"
FWD MASTHEAD LIGHT	107'-2 3/8"
STERN LIGHT (WHITE)	58'-7 1/2"
STERN LIGHT (BLUE)	57'-5 1/2"
WAKE LIGHT	59'-8"
AFT ANCHOR LIGHT	71'-6"
FWD ANCHOR LIGHT	89'-8 1/2"
SIDE LIGHT (STBD)	61'-3 3/8"
SIDE LIGHT (PORT)	61'-3 1/4"
YARDARM BLINKER LIGHTS P/S	163'-4"
ASW REVOLVING LIGHT	209'-1 1/4"
MAN OVERBOARD LIGHT(MIDDLE)	197'-1 1/2"
MAN OVERBOARD LIGHT(LOWER)	185'-1 1/4"
BREAKDOWN LIGHT (UPPER)	209'-1 1/4"
BREAKDOWN LIGHT (LOWER)	185'-1 1/4"
SHIPS TASK LIGHT (MIDDLE)	197'-1 1/2"
SHIPS TASK LIGHT (LOWER)	185'-1 1/4"
HOMING BEACON	168'-0"
AN/SAT-2 BLINKER LIGHTS P/S	162'-9"
FWD HULL CONTOUR LIGHT (P)	53'-10 3/4"
FWD HULL CONTOUR LIGHT (S)	53'-11 1/8"
AFT HULL CONTOUR LIGHT (P)	53'-11"
AFT HULL CONTOUR LIGHT (S)	53'-10 3/4"


BOATS

QTY	TYPE OF BOAT	NO. MEN EACH	TOTAL MEN
3	40 FOOT UTILITY BOAT MK 3	75	225
2	33 FOOT PERSONNEL BOAT MK 2	24	48
2	26 FOOT MOTOR WHALEBOAT MK 10	20	40
81	INFLATABLE LIFEBOAT MK 6	25	2025


ACCOMMODATIONS

	BEDS	BERTHS	LKRS
CAPTAIN'S SR	1		2
EXECUTIVE OFFICER'S SR	1		1
GUEST CABINS (02 LEVEL P/S)	2		2
CAPTAIN'S SEA CABIN (06 LEVEL)	1		1
CAPTAIN'S SEA CABIN (04 LEVEL)	1		1
OFFICERS		117	117
CPO		94	94
CREW		1524	1524
MARINES		44	44
OTHER (HOSPITAL & ISOLATION WARD)		24	24
(DETENTION)		8	4
TOTALS	6	1811	1814




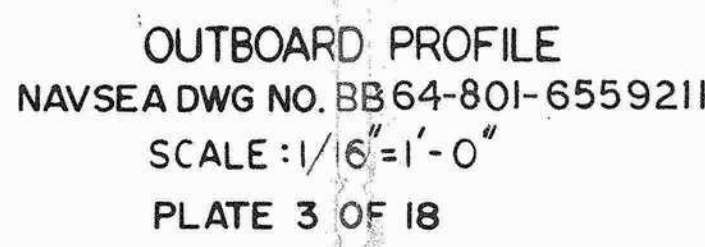




 


INBOARD PROFILE  
NAVSEA DWG NO. BB 64-801-6559211  
SCALE: 1/16"=1'-0"  
PLATE 4 OF 18




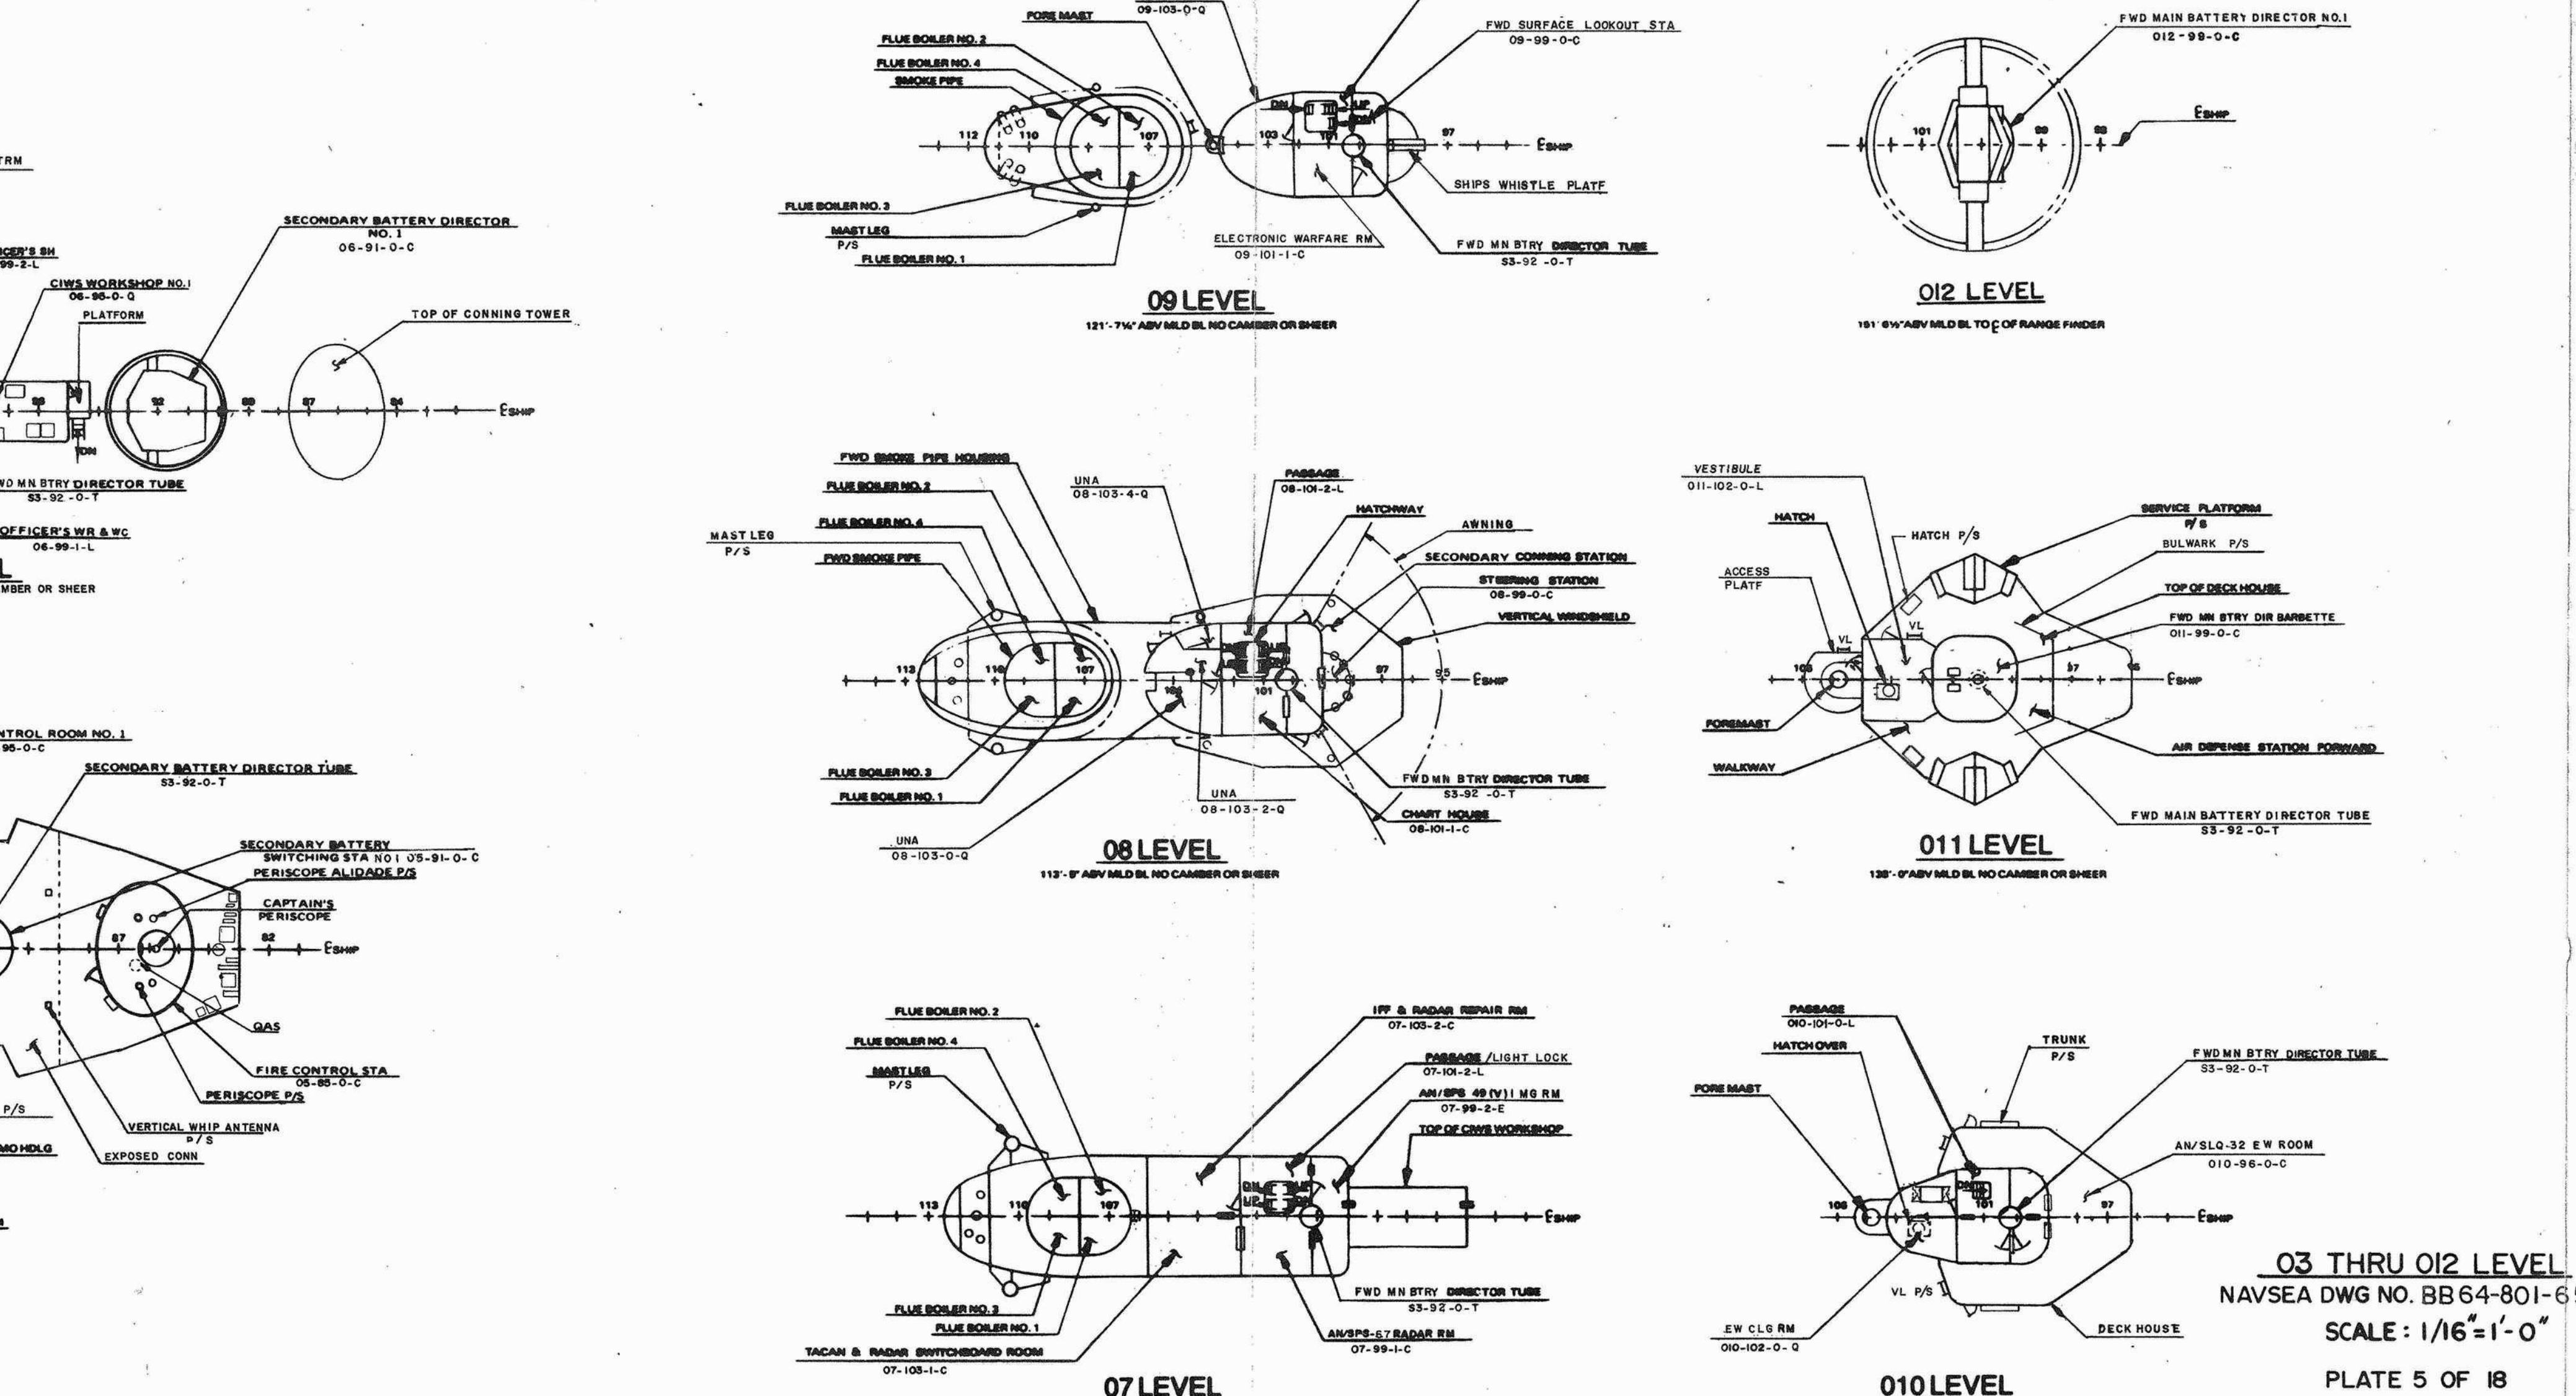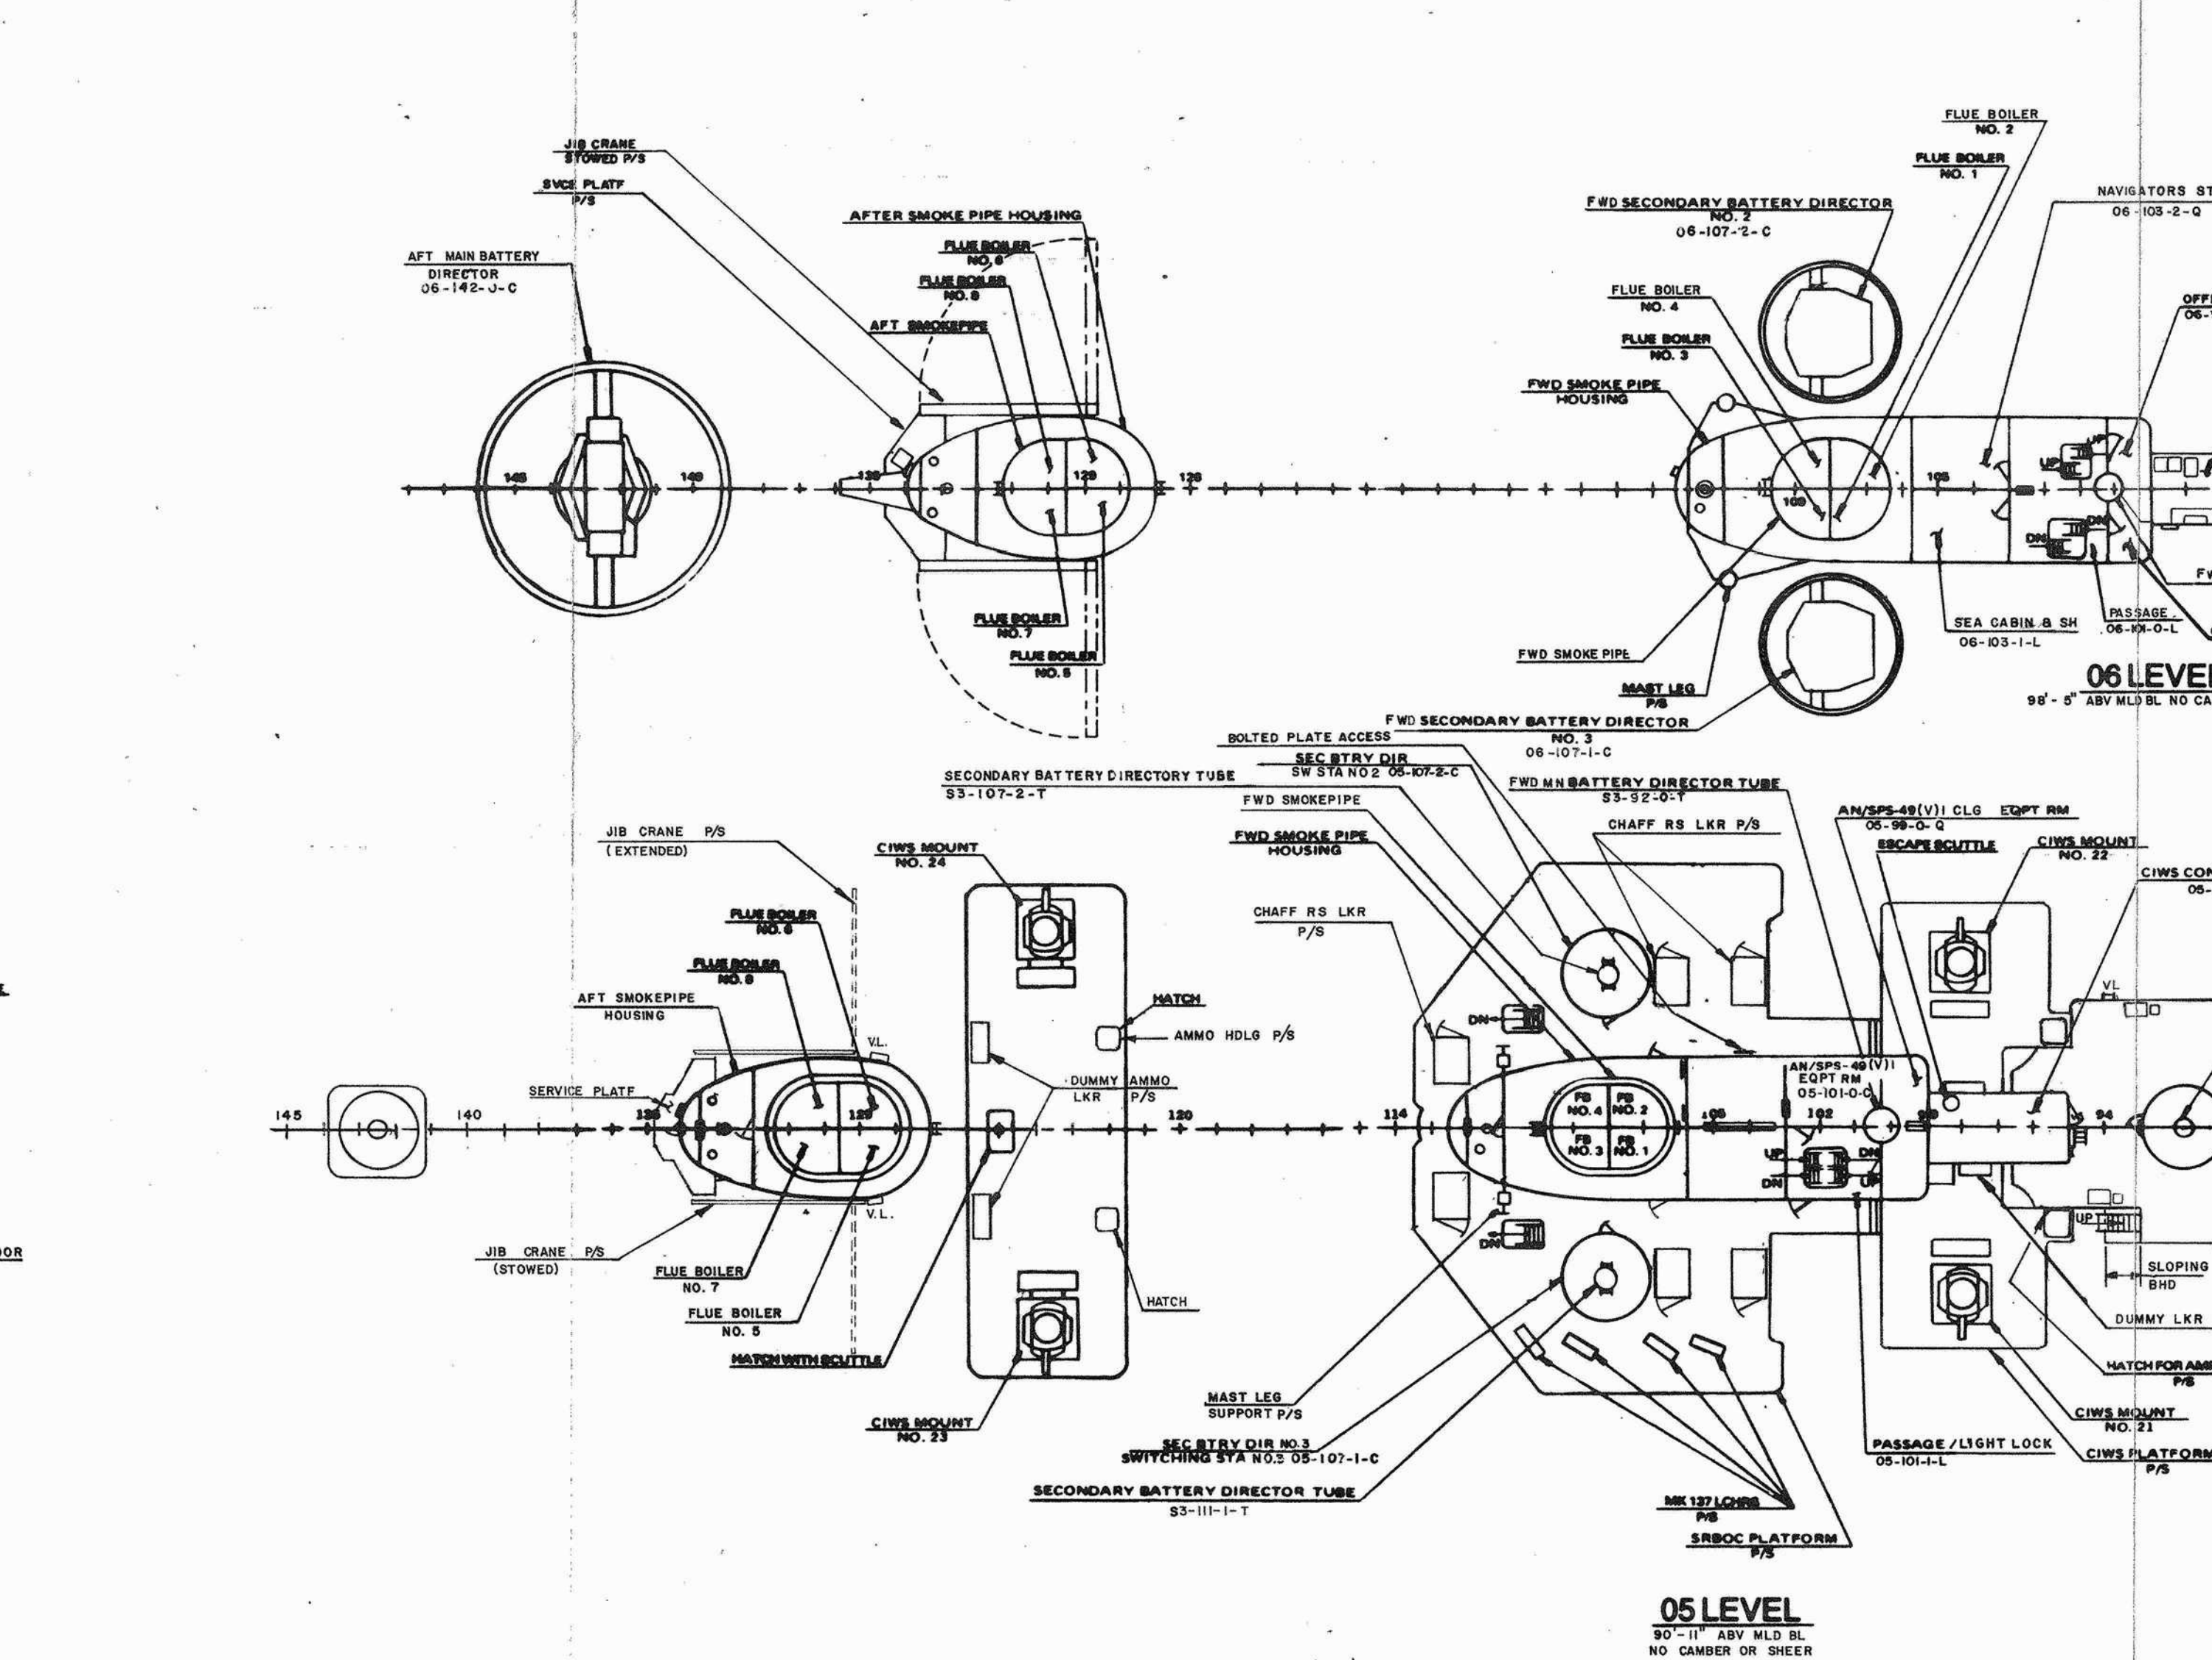



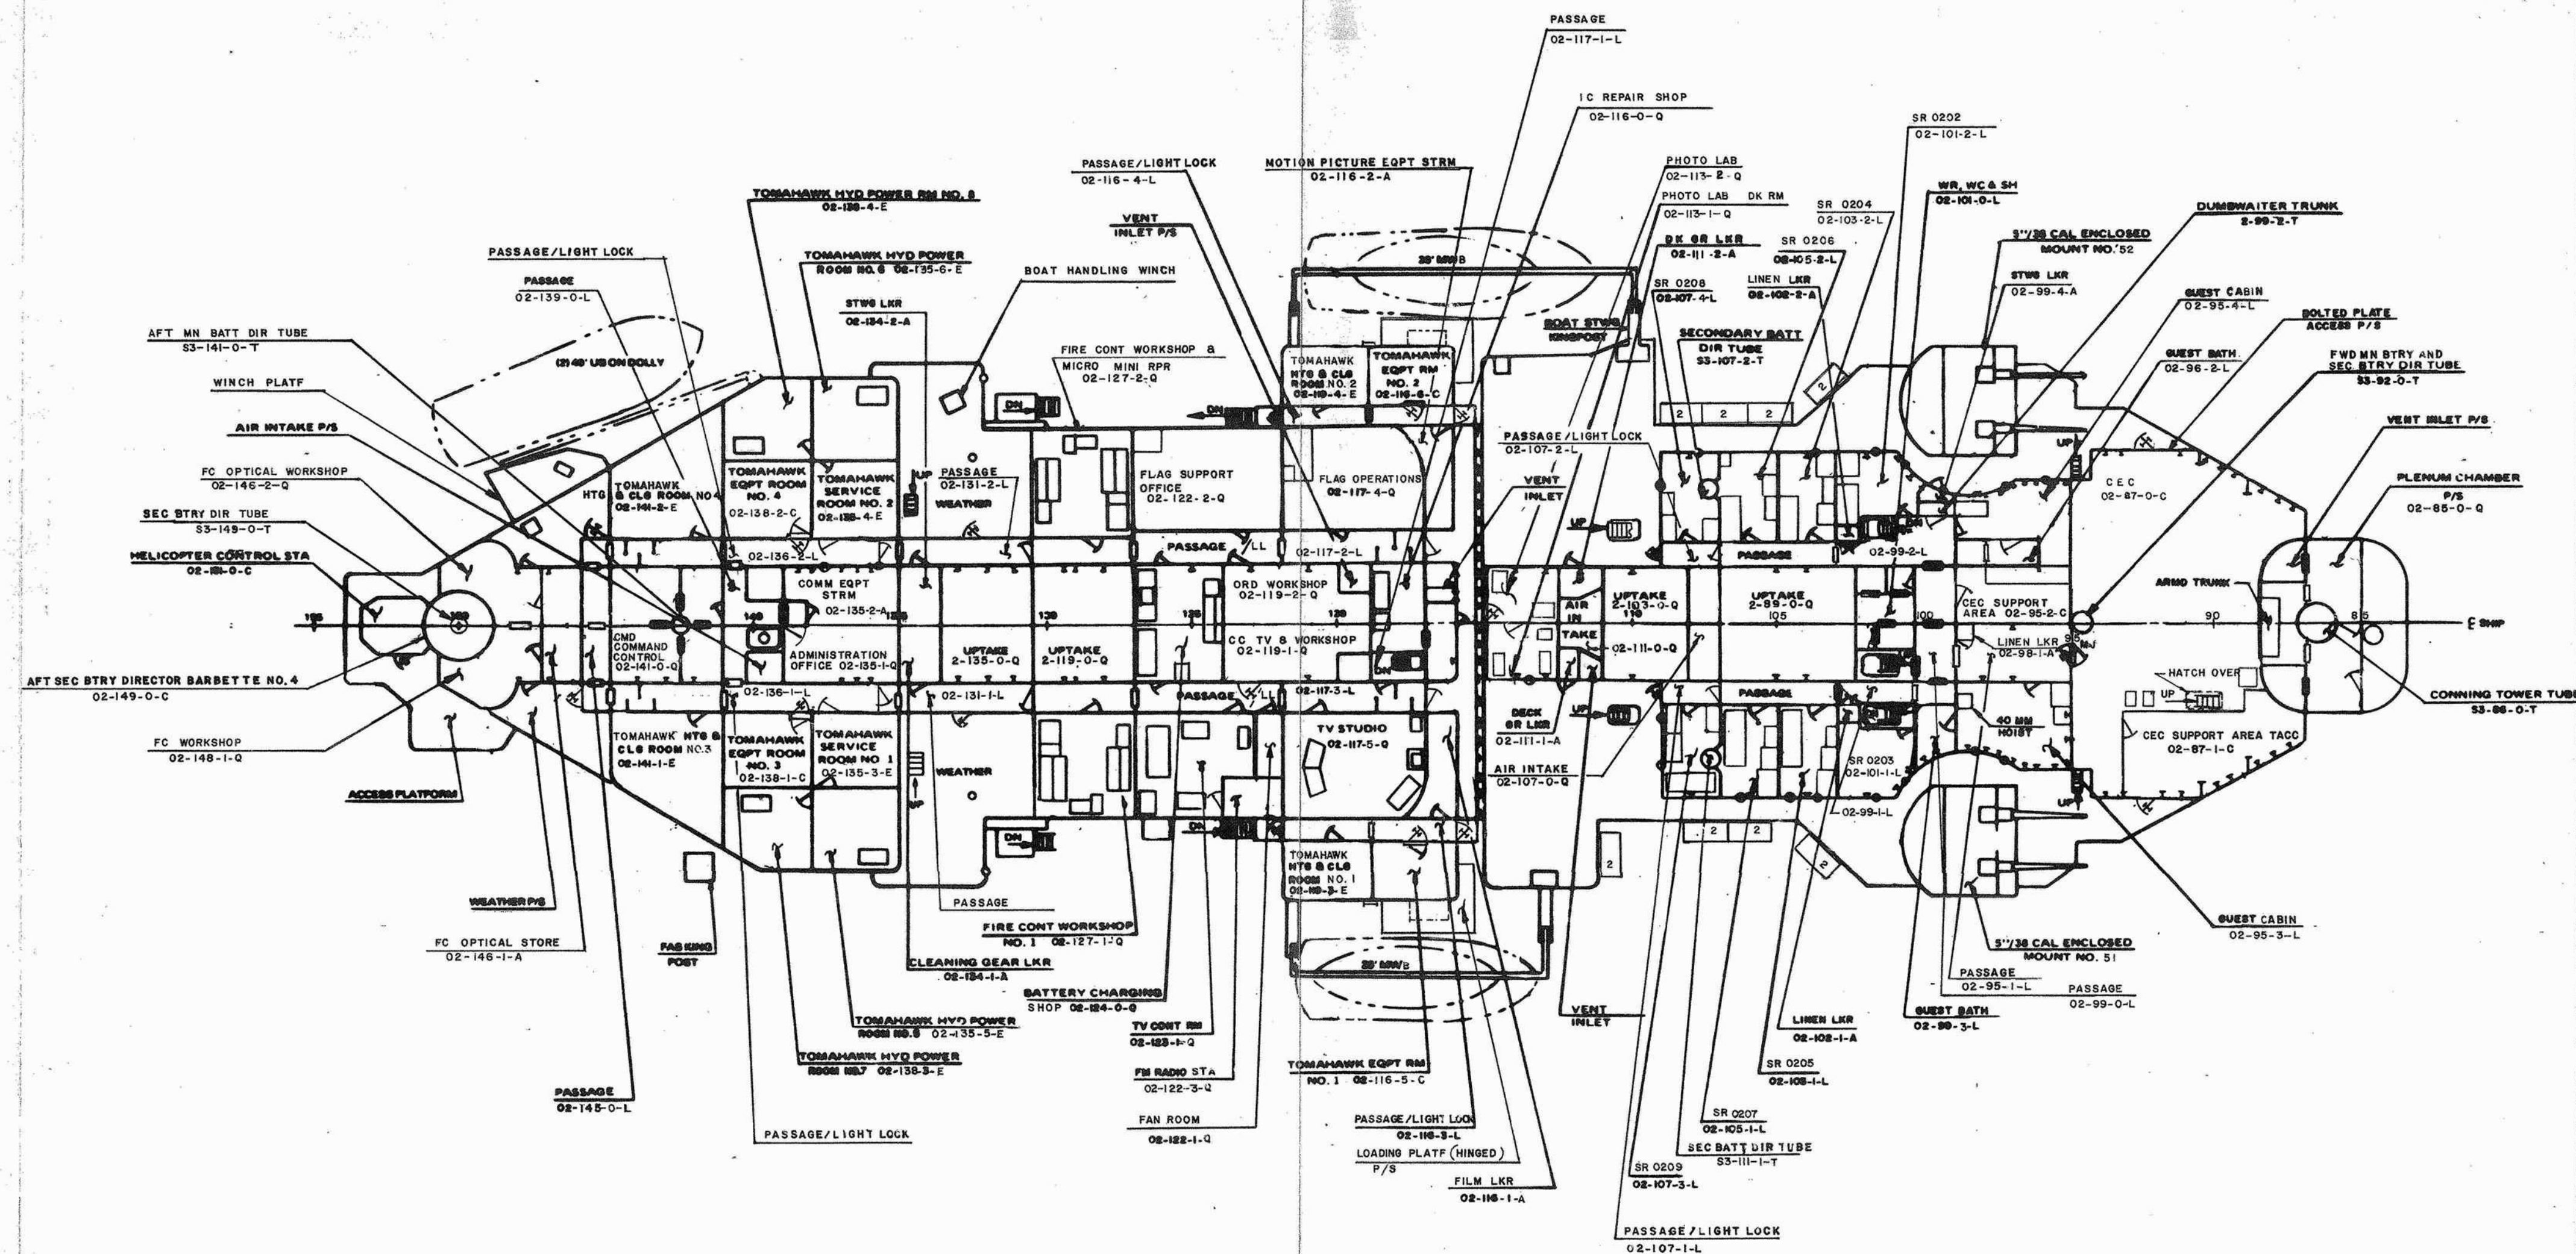


**02 LEVEL**  
62'5" ABV MLD BL  
CAMBER - NO SHEER

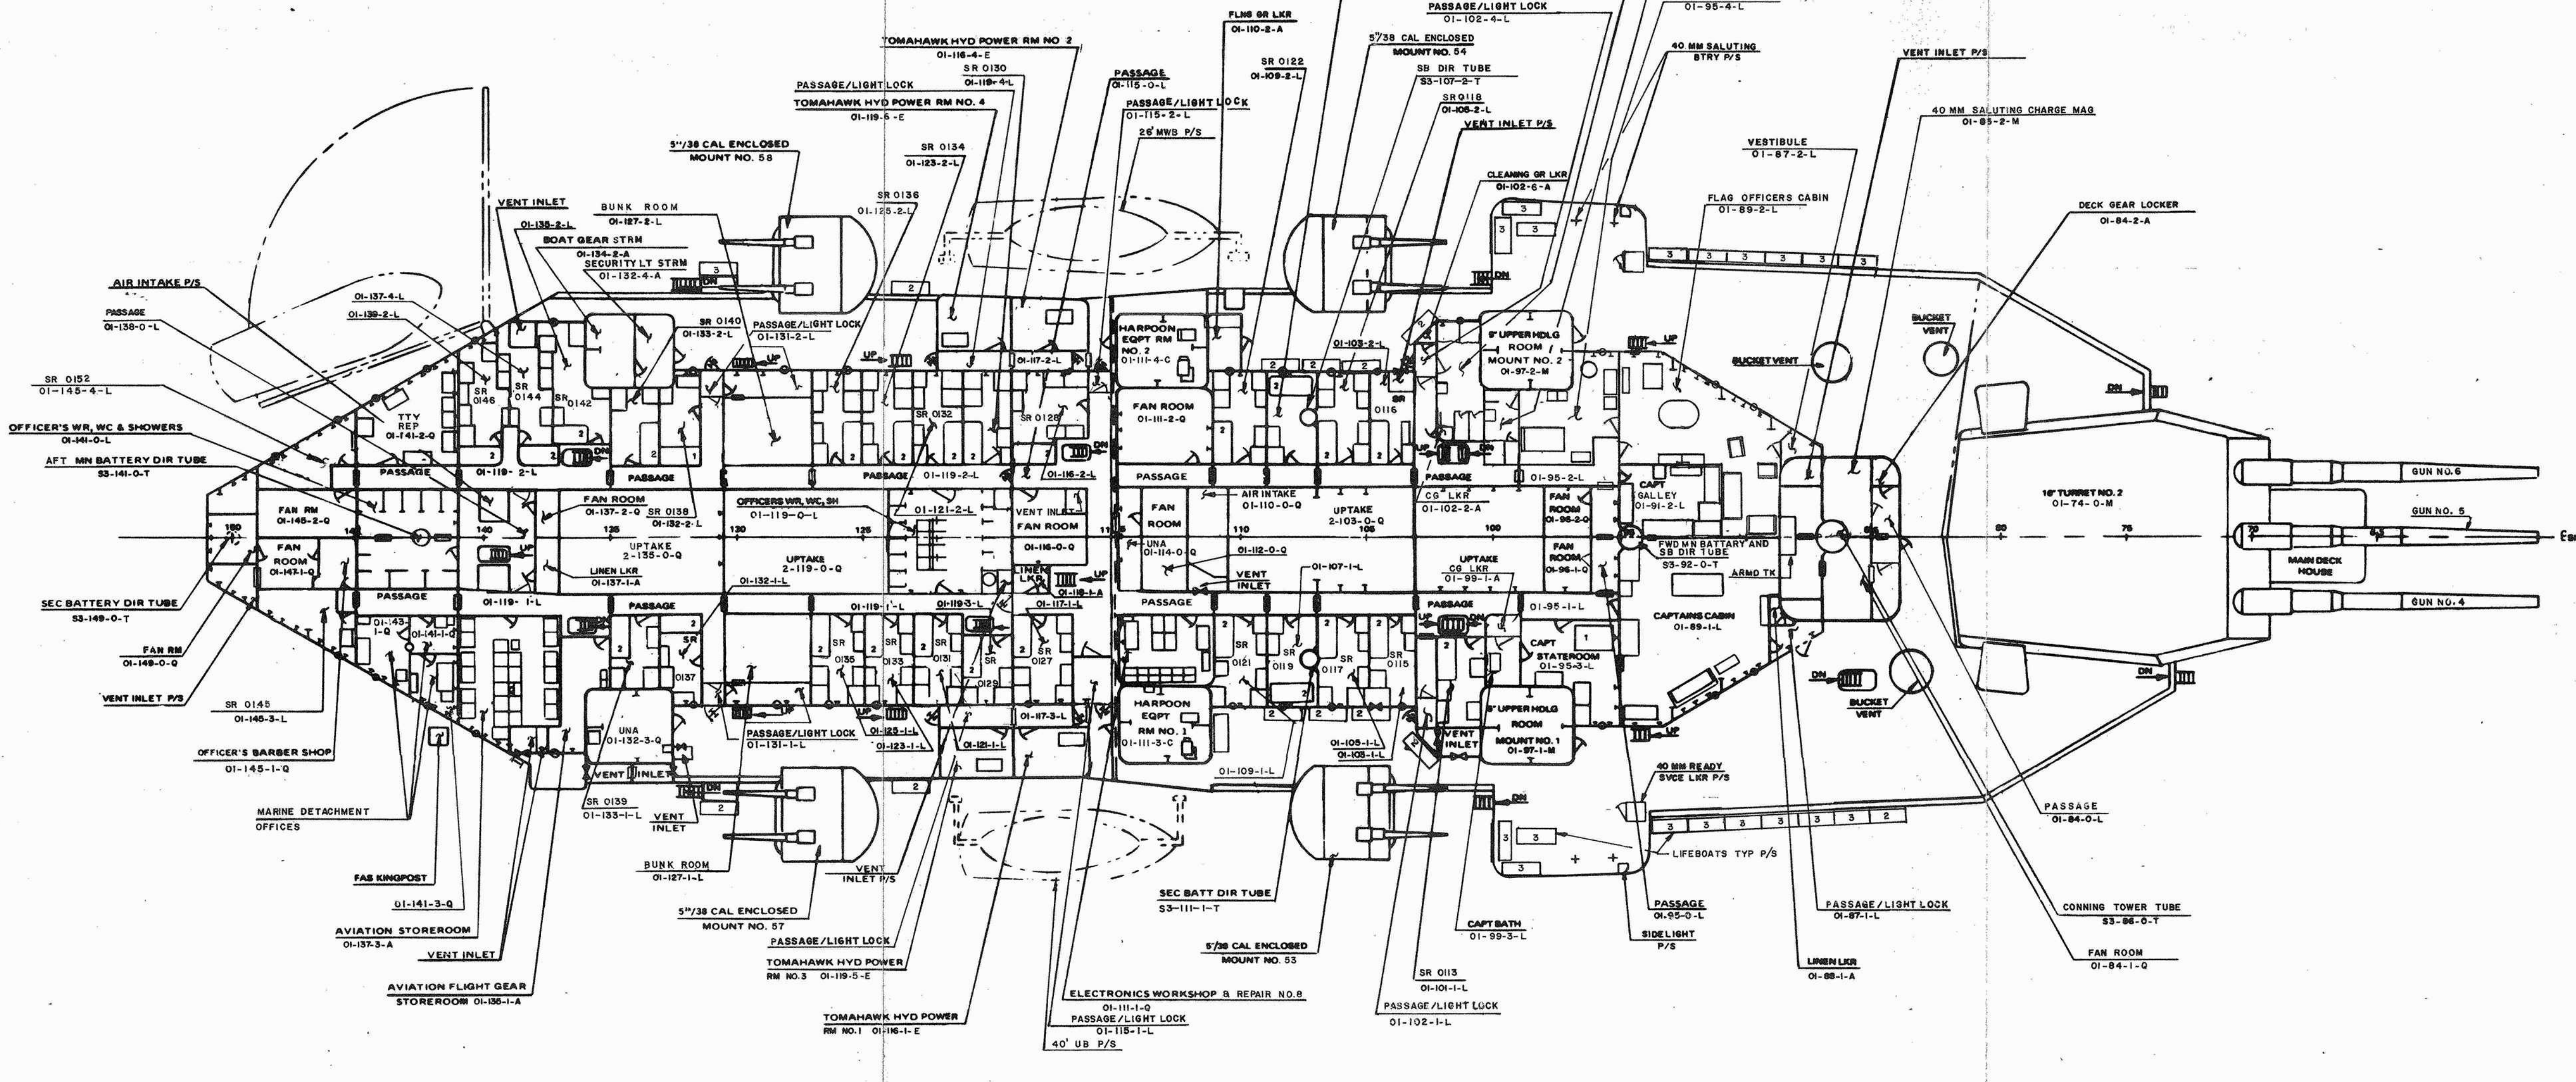


**01 LEVEL**  
60'11" ABV MLD BL  
CAMBER - NO SHEER




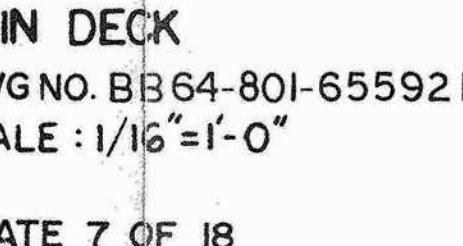



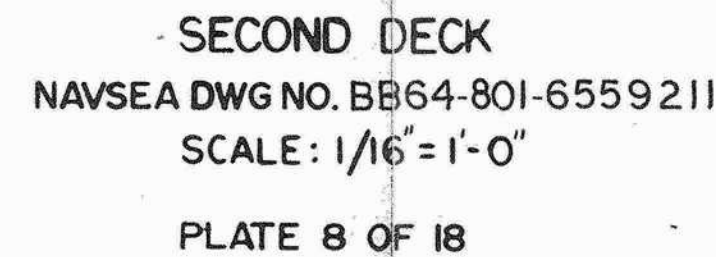




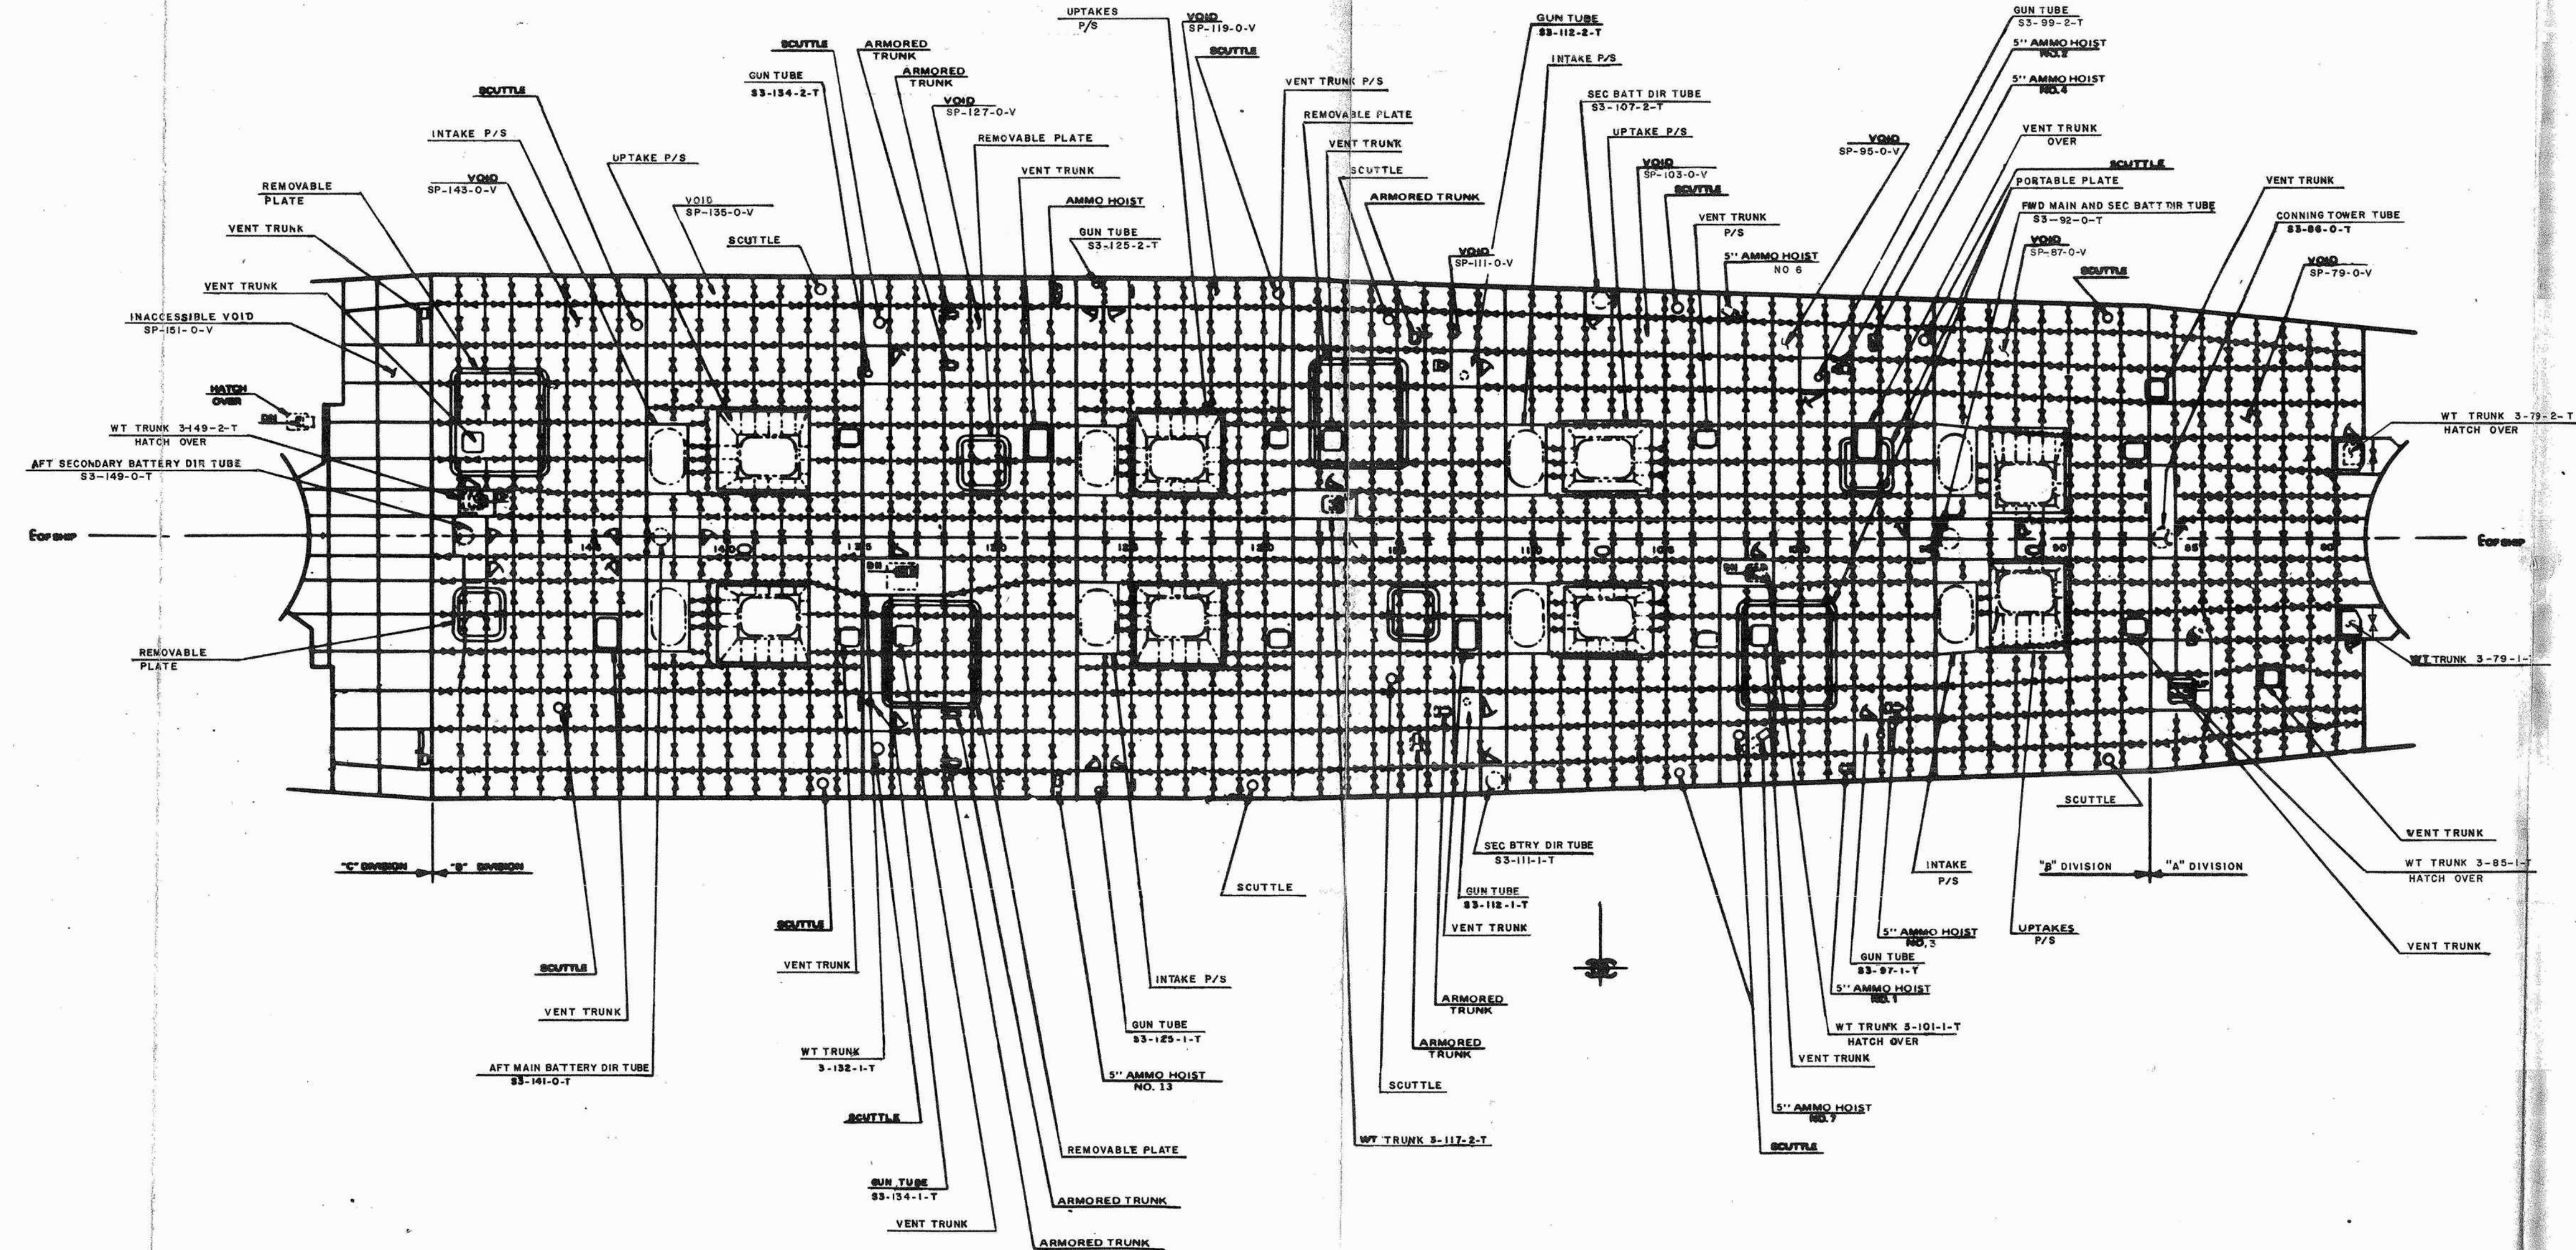

SPLINTER DECK  
 NAVSEADWGNO. BB64-801-6559211  
 SCALE: 1/16"=1'-0"  
 PLATE 9 OF 18



 

THIRD DECK  
NAVSEA DWG NO. BB64-801-6559211  
SCALE: 1/16"=1'-0"  
PLATE 10 OF 18












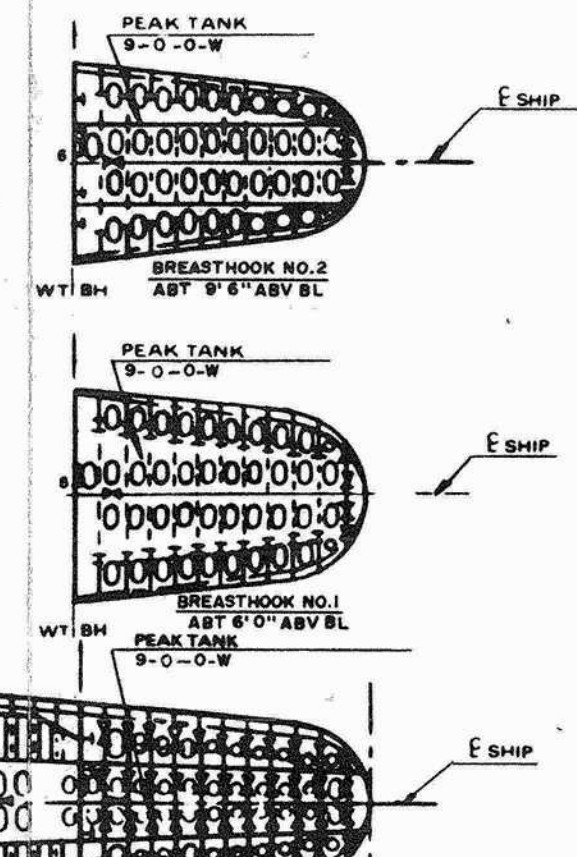

NAVSEA DWG NO. BB64-801-6559211  
SCALE: 1/16"=1'-0"  
PLATE 13 OF 18







